



## DEFENSE LOGISTICS AGENCY

Land and Maritime  
P.O. BOX 3990  
COLUMBUS, OH 43218-3990

15 April 2016

### MEMORANDUM FOR MILITARY/INDUSTRY DISTRIBUTION

SUBJECT: Initial Draft of DLA Land and Maritime drawing 15004A.  
Resistor, Fixed, Wire Wound (Accurate), 0.125 Watt (RBR71).  
Project numbers: 5905-2016-E31.

The subject draft of this document is being made available for review and comments. Particular attention should be paid to the following, as all data is suggestive: Changes and additions are highlight in yellow, and deletions are in red with strike outs.

#### DLA Land and Maritime drawing 15004A

Section 2 has been revised.  
Figure 1, Dimension "E" has been changed.  
Paragraphs 3.4 has been revised.

If this document is of interest to you, please provide your comments to the project engineer electronically. It is very important that you attempt to respond electronically to this initial draft. This can be in the form of a return e-mail, with or without an attached text file. Because we believe electronic coordination should be faster than hard copy distribution, we have allotted a 30-day coordination cycle from the date of this letter. Please provide your comments within that time period. After the 30-day cycle is completed, a **"no response" will be noted as concurrence** and any comments received after will be held until the next action. If an electronic response is not possible we will still accept comments via letter, facsimile or phone call but only after you have contacted the project officer listed below. The initial draft documents can be found at the following DLA Land and Maritime-VA web page:

<http://www.landandmaritime.dla.mil/Programs/MilSpec/initialdrafts.aspx>

This process still requires military departments to identify their comments as "Essential" or "Suggested". Essential comments must be justified with supporting data. Military review activities should forward comments to their custodians or this office, as applicable, in sufficient time to allow for consolidating the department reply.

If there are any questions, please contact Andrew Ernst by the preferred method of electronic mail at [andrew.ernst@dla.mil](mailto:andrew.ernst@dla.mil) by telephone at commercial 614-692-0552, DSN 850-0552; or by facsimile at 614-692-6939. Our mailing address as a last resort is DLA Land and Maritime, ATTN: VAT, P.O. Box 3990, Columbus, OH 43218-3990. If you have further questions or concerns you may contact me at [Michael.radecki@dla.mil](mailto:Michael.radecki@dla.mil), by telephone at 614-692-0561.

SIGNED

Michael Radecki  
Chief,  
Electronic Components Branch

REVISIONS			
LTR	DESCRIPTION	DATE	APPROVED
A	Figure 1, "E" dimension change. Revise marking paragraph. Editorial changes throughout.	DRAFT	DRAFT

DRAFT




Prepared in accordance with [ASME Y14.100](#)

REV STATUS OF PAGES	REV	A	A	A	A	A	A	A										
	PAGES	1	2	3	4	5	6	7										
PMIC N/A	PREPARED BY Andrew R. Ernst							DLA LAND AND MARITIME COLUMBUS, OH										
Original date of drawing 19 February 2015	CHECKED BY Andrew R. Ernst							TITLE RESISTOR, FIXED, WIREWOUND, (ACCURATE), 0.125 WATT (RBR71)										
	APPROVED BY Michael Radecki																	
	SIZE A	CODE IDENT. NO. 037Z3						DWG NO. 15004										
	REV A							PAGE 1 OF 7										

1. SCOPE

1.1 Scope. This drawing describes the requirements for a fixed, wirewound (accurate), 0.125 watt resistor.

1.2 Part or Identifying Number (PIN). The complete PIN is as shown in the following example:

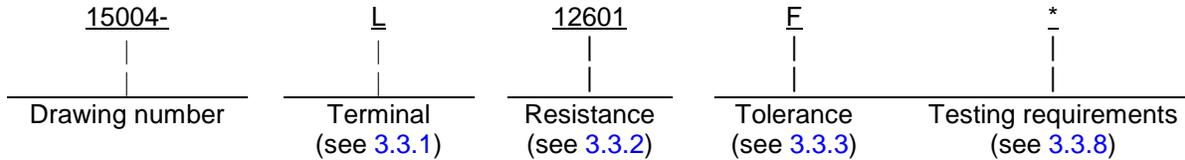

2. APPLICABLE DOCUMENTS

2.1 Government documents.

2.1.1 Specifications, standards, and handbooks. The following specifications, standards, and handbooks form a part of this document to the extent specified herein. Unless otherwise specified, the issues of these documents are those cited in the solicitation or contract.

DEPARTMENT OF DEFENSE SPECIFICATIONS

- MIL-PRF-39005 - Resistor, Fixed, Wirewound (Accurate), Nonestablished Reliability, and Established Reliability, General Specification for.
- MIL-PRF-39005/6 - Resistor, Fixed, Wirewound (Accurate), Nonestablished Reliability, and Established Reliability, Style RBR71.

DEPARTMENT OF DEFENSE STANDARDS

- ~~MIL-STD-202 - Test Methods for Electronic and Electrical Component Parts.~~
- MIL-STD-690 - Failure Rate Sampling Plans and Procedures.
- MIL-STD-790 - Established Reliability and High Reliability Qualified Products List (QPL) Systems for Electrical, Electronic, and Fiber Optic Parts Specifications.

(Copies of these documents are available online at <http://quicksearch.dla.mil>.)


2.2 Order of precedence. Unless otherwise noted herein or in the contract or in the event of a conflict between the text of this document and the references cited herein (except for related specification sheets), the text of this document takes precedence. Nothing in this document, however, supersedes applicable laws and regulations unless a specific exemption has been obtained.

3. REQUIREMENTS

3.1 Item requirements. The individual item requirements shall be in accordance with MIL-PRF-39005, and as specified herein.

3.2 Interface and physical dimensions. The resistor shall meet the interface and physical dimensions as specified in MIL-PRF-39005/6 and herein (see figure 1).

<b>DLA LAND AND MARITIME COLUMBUS, OHIO</b>	<b>SIZE A</b>	<b>CODE IDENT NO. 037Z3</b>	<b>DWG NO. 15004</b>
		REV A	PAGE 2

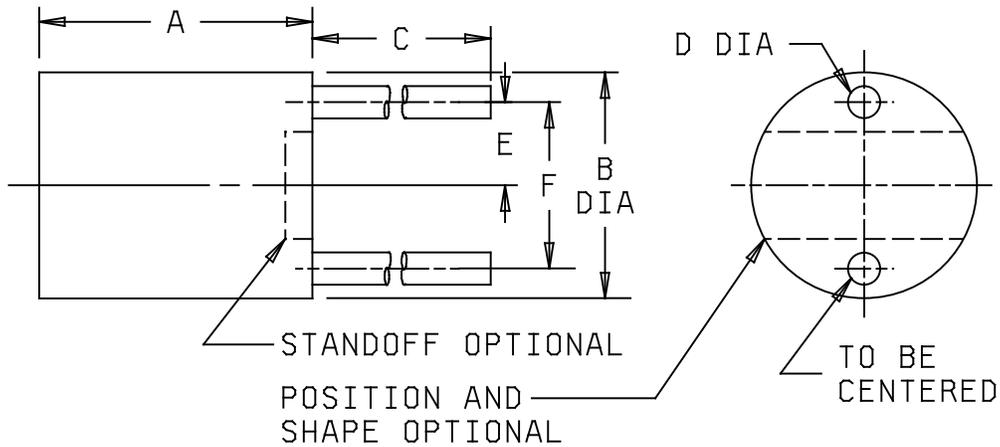

Dimension	Inches	Millimeters
A	0.312±0.031	7.93±0.79
B	0.250 ±0.031	6.35 ±0.79
C	1.000 min	25.40 min
D	0.025 ±0.002	0.64 ±0.05
E	0.100 ± <del>0.002</del> ±0.010	2.54 ± <del>0.05</del> ±0.25
F	0.200 ±0.010	5.08 ±0.25

NOTES:

1. Dimensions are in inches.
2. Metric equivalents are in parenthesis.
3. Resistance measurement points for all values of resistance shall be .375 ±.0625 (9.53 mm ±1.588 mm) from the end of the body.

FIGURE 1. Style RBR71 resistor.

3.3 Electrical characteristics.

3.3.1 Terminal. The terminal is identified by a single letter in accordance with table I.

TABLE I. Terminal.

Symbol	Terminal
L	Solderable
U	Weldable

<b>DLA LAND AND MARITIME COLUMBUS, OHIO</b>	<b>SIZE A</b>	<b>CODE IDENT NO. 037Z3</b>	<b>DWG NO. 15004</b>
		REV A	PAGE 3

3.3.2 Resistance. The nominal resistance is expressed in ohms and is identified by five digits; the first four digits represent significant figures and the last digit specifies the number of zeroes to follow. When the values of resistance are less than 1,000 ohms, or when fractional values of an ohm are required, the letter "R" is substituted for one of the significant digits to represent the decimal point. When the letter "R" is used, succeeding digits of the group represent significant figures. The resistance value designations are in accordance with MIL-PRF-39005. Minimum resistance values are as specified in 3.3.2.1, and maximum resistance values are as specified in table II. The standard values for every decade are in accordance with the "10 to 100" decade table of MIL-PRF-39005. The resistance values for 0.01 percent (T), 0.02 percent (Q), 0.05 percent (A) and 0.1 percent (B) resistance tolerances may be of any value, but it is preferred that the values are chosen within the "10 to 100" decade table of MIL-PRF-39005.

3.3.2.1 Minimum resistance value and applicable tolerance. Minimum resistance value shall be 0.1 ohm for tolerance F ( $\pm 1.0$  percent). For tolerances B, A, Q, T ( $\pm 0.10$ ,  $\pm 0.05$ ,  $\pm 0.02$ , and  $\pm 0.01$  percent, respectively), the minimum resistance value shall be 10 ohms.

3.3.2.2 Maximum resistance value. Maximum resistance values and applicable wire sizes shall be in accordance with table II.

TABLE II. Maximum resistance values.

Nominal wire size (inches) diameter	Absolute diameter	Maximum resistance value (megohms)
.001	.0009	.100
.0009	.00081	.130
.0008	.00072	.150

3.3.3 Resistance tolerance. Resistors are available in resistance tolerances in accordance with table III.

TABLE III. Resistance and resistance tolerance.

Symbol	Initial resistance tolerance (at 25°C $\pm 2^\circ\text{C}$ )
T	$\pm 0.01$ percent
Q	$\pm 0.02$ percent
A	$\pm 0.05$ percent
B	$\pm 0.10$ percent
F	$\pm 1.00$ percent

3.3.5 Power rating. The power rating shall be 0.125 watt. Resistors power rating is based on continuous full load operation at an ambient temperature of +125°C. For temperature in excess of +125°C, the load shall be derated in accordance with figure 2.

3.3.6 Voltage rating. The maximum voltage shall be 150 volts direct current or peak.

3.3.7 Maximum weight. The maximum weight shall be 1.5 grams.

<b>DLA LAND AND MARITIME COLUMBUS, OHIO</b>	<b>SIZE A</b>	<b>CODE IDENT NO. 037Z3</b>	<b>DWG NO. 15004</b>
		REV A	PAGE 4

3.3.8 Testing requirements. The requirement for testing shall be identified by a single letter in accordance with table IV.

TABLE IV. Testing.

Symbol	Testing requirements
(blank)	Group A
A	Group A and Group B

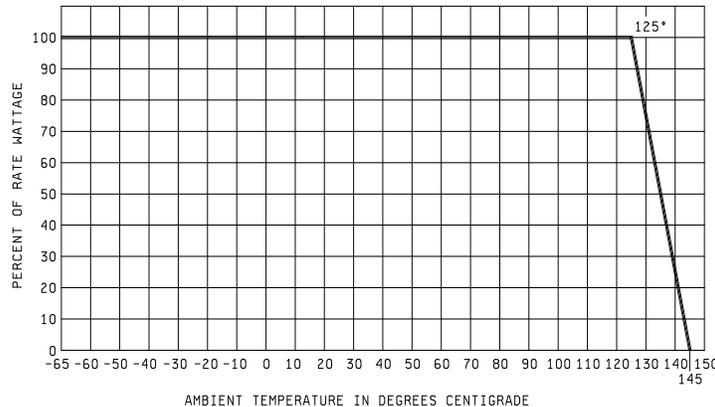


FIGURE 2. Derating curve for high ambient temperatures.

\* 3.4 Marking. ~~Resistors shall be marked with the PIN assigned herein (see 1.2) and manufacturer's identification code (CAGE or logo), date code, and lot code.~~

3.4 Marking. Resistors shall be marked as follows:

- XXXXXX - Manufacturer's identification code (CAGE or logo)
- 15004L - DLA Land and Maritime drawing number and Terminal
- 12701F - Coded resistance value, and Tolerance.
- XXXXXX - Date code, and Lot code.

The complete marking is required on the unit package. Unit packages shall be marked with the PIN assigned herein (see 1.2) and manufacturer's identification code (CAGE or logo), date code, and lot code.

3.5 Pure tin. The use of pure tin, as an underplate or final finish is prohibited both internally and externally. Tin content of resistor components and solder shall not exceed 97 percent, by mass. Tin shall be alloyed with a minimum of 3 percent lead, by mass (see 6.3).

3.6 Recycling, recovered, environmentally preferable or biobased materials. Recycled, recovered, environmentally preferable or biobased materials should be used to the maximum extent possible provided that the material meets or exceeds the operational and maintenance requirements, and promotes economically advantageous life cycle costs.

<b>DLA LAND AND MARITIME COLUMBUS, OHIO</b>	<b>SIZE A</b>	<b>CODE IDENT NO. 037Z3</b>	<b>DWG NO. 15004</b>
		<b>REV A</b>	<b>PAGE 5</b>

3.7 Manufacturer eligibility. To be eligible for listing as an approved source of supply, a manufacturer shall be listed on the MIL-PRF-39005 Qualified Products List for at least one part, or perform the group A and group B inspections specified herein on a sample agreed upon by the manufacturer and DLA Land and Maritime-VAT.

3.7.1 Certificate of compliance. A certificate of compliance shall be required from manufacturers requesting to be an approved source of supply.

3.8 Workmanship. Resistors shall be uniform in quality and free from defects that will affect life, serviceability, or appearance.

#### 4. VERIFICATIONS

4.1 Product assurance program. The product assurance program specified in MIL-PRF-39005 and maintained in accordance with MIL-STD-790 is not applicable to this document.

4.2 Product level qualification. The product level qualification specified in MIL-PRF-39005 and MIL-STD-690 is not applicable to this document.

4.3 Conformance provisions.

4.3.1 Inspection of product for delivery. Inspection of product for delivery shall consist of group A inspection and group B inspection of MIL-PRF-39005.

4.3.2 Group A inspection. Group A inspection shall be in accordance with MIL-PRF-39005.

4.3.3 Group B inspection. Group B inspection shall be in accordance with MIL-PRF-39005.

4.3.3.1 Certification. The acquiring activity, at its discretion, may accept a certificate of compliance with group B requirements in lieu of performing group B tests (see 6.2d).

4.4 Visual and mechanical examination. Resistors shall be examined to verify that the materials, design, construction, physical dimensions, marking, and workmanship are in accordance with the applicable requirements of MIL-PRF-39005.

#### 5. PACKAGING

5.1 Packaging. For acquisition purposes, the packaging requirements shall be as specified in the contract or order (see 6.2). When packaging of materiel is to be performed by DoD or in-house contractor personnel, these personnel need to contact the responsible packaging activity to ascertain packaging requirements. Packaging requirements are maintained by the Inventory Control Point's packaging activity within the Military Department or Defense Agency, or within the military service's system commands. Packaging data retrieval is available from the managing Military Department's or Defense Agency's automated packaging files, CD-ROM products, or by contacting the responsible packaging activity.

#### 6. NOTES

(This section contains information of a general or explanatory nature that may be helpful, but is not mandatory.)

6.1 Intended use. Resistors are intended for use in dc amplifiers, voltmeter multipliers, electronic computers, meters, and laboratory test equipment.

6.2 Ordering data. The contract or purchase order will specify the following:

a. Complete PIN (see 1.2).

<b>DLA LAND AND MARITIME COLUMBUS, OHIO</b>	<b>SIZE A</b>	<b>CODE IDENT NO. 037Z3</b>	<b>DWG NO. 15004</b>
		REV A	PAGE 6

- b. Requirements for delivery: One copy of the conformance inspection data that parts have passed conformance inspection, with each shipment of parts by the manufacturer.
- c. Packaging requirements (see 5.1).
- d. Whether the manufacturer performs the group B inspection or provides a certificate of compliance (see 4.3.3.1).

6.3 Tin whisker growth. The use of alloys with tin content greater than 97 percent, by mass, may exhibit tin whisker growth problems after manufacture. Tin whiskers may occur anytime from a day to years after manufacture and can develop under typical operating conditions, on products that use such materials. Conformal coatings applied over top of a whisker-prone surface will not prevent the formation of tin whiskers. Alloys of 3 percent lead, by mass, have shown to inhibit the growth of tin whiskers. For additional information on this matter, refer to [ASTM-B545](#) (Standard Specification for Electrodeposited Coatings of Tin).

6.4 Supplementary insulation. Where potential to ground is over 250 volts, supplementary insulation should be provided.

6.5 High voltages, high resistance's (or both) and high altitudes. Where voltages higher than 250 volts rms are present between the resistor circuit and grounded surface on which the resistor is mounted, or where the resistance is so high that the insulation resistance to ground is an important factor, precautionary measures should be taken.

6.6 Low tolerance resistors. Low tolerance resistors (.005 and .01), exhibiting resistance shifts due to high humidity are normal to precision, fixed resistors. Before being considered out of tolerance, resistors should be conditioned in a dry oven. Users of said resistors should contact suppliers for temperature and drying times. Resistors which continue to be out of tolerance after the above conditioning process should be considered rejects.

6.7 MIL-PRF-39005/6 replacements. The resistors described herein are possible replacements for MIL-PRF-39005/6 (RBR71) resistors. Users are cautioned to evaluate this document for their particular application before citing it as a replacement document. [MIL-PRF-39005/6](#) resistors have failure rate levels (FRL) established in accordance with MIL-STD-690. DLA Land and Maritime drawing 15004 resistors are non-established reliability.

6.8 User of record. Coordination of this document for future revisions is coordinated only with the approved source of supply and the users of record of this document. Requests to be added as a recorded user of this drawing may be achieved online at [resistor@dla.mil](mailto:resistor@dla.mil) or in writing to: DLA Land and Maritime, Attn: VAT, Post Office Box 3990, Columbus, OH 43218-3990 or by telephone (614) 692-0552 or DSN 850-0552.

6.9 Approved source of supply. Approved source of supply is listed herein. Additional sources will be added as they become available. Assistance in the use of this drawing may be obtained online at [resistor@dla.mil](mailto:resistor@dla.mil) or contact DLA Land and Maritime, Attn: VAT, Post Office Box 3990, Columbus, OH 43218-3990 or by telephone (614) 692-0552 or DSN 850-0552.

DLA Land and Maritime drawing PIN 15004-*****	Vendor similar designation or type number 1/	Vendor CAGE	Vendor name and address
Terminal: L and U Tolerance and Resistance: All tolerance and Ohmic values	203PA	44655	Ohmite Manufacturing Company 27501 Bella Vista Parkway Warrenville, IL 60555  Plant: Victoreen de Mexico S.A. de C.V., Oriente 2, #46 Cd. Industrial Apdo. Postal 171 Matamoros. Tam. 87499, MX

1/ Parts must be purchased to the DLA Land and Maritime PIN to assure that all performance requirements and tests are met.

<b>DLA LAND AND MARITIME COLUMBUS, OHIO</b>	<b>SIZE A</b>	<b>CODE IDENT NO. 037Z3</b>	<b>DWG NO. 15004</b>
		<b>REV A</b>	<b>PAGE 7</b>